ITB 25-04 Old Spring House Ln Shared Use Path Addendum #1

June 16, 2025

Responses to questions received through June 13, 2025:

1. Can you please check the following quantities? Base Bid DROP INLET, GP 1 ADDL DEPTH, and CONC SIDEWALK, 4 IN Alternate Bid HOT APPLIED PREFORMED PVMT MKG. WORDS AND/OR SYMBOLS, WHITE TP P **RESPONSE: Certain pay items in the Base Bid have quantities of zero (0) because in the item is not needed as part of the Base Bid design. The pay items in the Alternate Bid with a quantity of zero (0) because the pay item is not needed as part of the Alternate Bid design.**

Addendum 1 Summary

- Addendum 1 responds to all questions received through **June 13, 2025.**
- The Base Bid and Alternate Bid have been revised with modifications and/or additions. All revisions have been marked in Red. Contractor must use the revised bid schedules.
- Notes included on plan sheet 5-0001 for clarity.
- Notes included on plan sheet 6-0001 for clarity.
- Notes included on plan sheet 6-0003 for clarity.
- Addendum 1 also details on plan sheet 13-01 and 13-02 the work identified as part of the Base Bid and the Alternate Bid. The work associated with the alternate bid consists of the construction of sidewalk, curb and gutter, driveways, drainage structures and a road width reduction. The work for the Alternate Bid is on the North side of the project and is highlighted in Red on the Plan Sheets 13-01 and 13-02 “Addendum 1”

ITB 25-04: OLD SPRING HOUSE LANE SHARED USE PATH

BASE BID – Addendum 1

ITEM NO.	DESCRIPTION	UNIT	QTY	UNIT PRICE	EXTENDED COST
	ROADWAY				
150-1000	TRAFIC CONTROL – OLD SPRINGHOUSE LANE SHARED USE PATH	LS	1		
205-0210	EXCAVATION – ROCK-SPECIAL PROV (AS DIRECTED BY CITY ENGINEER)	CY	15		
206-0002	BORROW EXCAV, INCL MATL-SPECIAL PROV (AS DIRECTED BY CITY ENGINEER)	CY	100		
207-0203	FOUND BKFL MATL, TP 2 (AS DIRECTED BY CITY ENGINEER)	CY	100		
210-0100	GRADING COMPLETE – OLD SPRINGHOUSELANE SHARED USE PATH	LS	1		
310-1101	GR AGGR BASE CRS, INCL MATL	TN	170		
318-3000	AGGR SURF CRS	TN	90		
402-1802	RECYCLED ASPHALT CONC PATCHING, INCL BITUM MATL & H LIME	TN	100		
402-1812	RECYCLED ASPH CONC LEVELING, INCL BITUM MATL & H LIME	TN	5		
402-3130	RECYCLED ASPH CONC 12.5 MM SUPERPAVE, GP 2 ONLY, INCL BITUM MATL & H LIME	TN	310		
402-3190	RECYCLED ASPH CONC 19 MM SUPERPAVE, GP 1 OR 2, INCL BITUM MATL & H LIME	TN	30		
413-0750	BITUM TACK COAT	GL	415		
415-5000	ASPHALTIC CONCRETE OPEN GRADED CRACK RELIEF INTERLAYER, GP 2 ONLY, INCL BITUM MATL & H LIME	TN	200		
432-0210	MILL ASPH CONC PVMT, 2-1/2 IN DEPTH	SY	3,500		
441-0104	CONC SIDEWALK, 4 IN	SY	0		
441-0106	CONC SIDEWALK, 6 IN	SY	620		
441-0108	CONC SIDEWALK, 8 IN	SY	110		
441-5002	CONC HEADER CURB, 6 IN, TP 2	LF	20		
441-5004	CONC HEADER CURB, 10 IN, TP 4	LF	70		
441-6216	CONC CURB & GUTTER, 8 IN X 24 IN, TP 2	LF	780		
515-2050	HANDRAIL, SPECIAL DESIGN	LF	410		
550-5180	STORM DRAIN PIPE, 18 IN, CLASS III	LF	109		
550-5242	STORM DRAIN PIPE, 24 IN, CLASS IV	LF	32		
550-5420	STORM DRAIN PIPE, 42 IN, CLASS III	LF	140		
611-3010	RECONSTR DROP INLET, GP 1	EA	1		
611-3030	RECONSTR STORM SEWER MANHOLE, TP 1	EA	1		
668-2100	DROP INLET, GP 1	EA	2		
668-2110	DROP INLET, GP 1, ADDL DEPTH	LF	0		
668-2200	DROP INLET, GP 2	EA	1		

668-2210	DROP INLET, GP 2, ADDL DEPTH	LF	2		
668-4300	STORM SEWER MANHOLE, TP 1	EA	2		
668-4311	STORM SEWER MANHOLE, TP 1, ADDL DEPTH, CL 1	LF	2		
668-4312	STORM SEWER MANHOLE, TP 1, ADDL DEPTH, CL 2	LF	6		
	PERMANENT EROSION CONTROL				
700-9300	SOD	SY	510		
	TEMPORARY EROSION CONTROL				
163-0232	TEMPORARY GRASSING	AC	1		
163-0240	MULCH	TN	10		
163-0300	CONSTRUCTION EXIT	EA	1		
163-0550	CONSTRUCT AND REMPOVE INLET SEDIMENT TRAP	EA	7		
165-0010	MAINTENANCE OF TEMPORARY SILT FENCE, TP A	LF	50		
165-0030	MAINTENANCE OF TEMPORARY SILT FENCE, TP C	LF	190		
165-0101	MAINTENANCE OF CONSTRUCTION EXIT	EA	1		
165-0105	MAINTENANCE OF INLET SEDIMENT TRAP	EA	7		
171-0010	TEMPORARY SILT FENCE, TP A	LF	100		
171-0030	TEMPORARY SILT FENCE, TP C	LF	380		
700-8000	FERTILIZER MIXED GRADE	TN	1		
	SIGNING AND MARKING				
636-1033	HIGHWAY SIGNS, TP 1 MATL, REFL SHEETING, TP 9	SF	13		
636-1036	HIGHWAY SIGNS, TP 1 MATL, REFL SHEETING, TP 11	SF	6		
636-2070	GALV STEEL POSTS, TP 7	LF	51		
653-0120	THERMOPLASTIC PVMT MARKING, ARROW TP 1	EA	2		
653-1501	THERMOPLASTIC SOILD TRAF STRIPE, 5 IN, WHITE	LF	940		
653-1502	THERMOPLASTIC SOILD TRAF STRIPE, 5 IN, YELLOW	LF	2,000		
653-1704	THERMOPLASTIC SOLID TRAF STRIPE, 24 IN, WHITE	LF	32		
653-1804	THERMOPLASTIC SOLID TRAF STRIPE, 8 IN, WHITE	LF	190		
653-3501	THERMOPLASTIC SKIP TRAF STRIPE, 5 IN, WHITE	GLF	70		
653-6004	THERMOPLASTIC TRAF STRIPING, WHITE	SY	96		
653-6006	THERMOPLASTIC TRAF STRIPING, YELLOW	SY	43		
654-1001	RAISED PVMT MARKERS TP 1	EA	49		
654-1003	RAISED PVMT MARKERS TP 3	EA	4		
659-5013	HOT APPLIED PREFORMED PVMT MKG. WORDS AND/OR SYMBOLS, WHITE TP P	EA	2		

	RETAINING WALLS				
500-3201	CLASS B CONCRETE, RETAINING WALL-GRANITE FACED	CY	176		
	WATER AND SEWER				
611-5592	RELOCATE WATER METER	EA	2		
660-2600	SEWER CLEANOUTS	EA	1		
670-1650	BACKFLOW PREVENTION ASSEMBLY	EA	2		
670-9710	RELOCATE EXISTING FIRE HYDRANT	EA	1		
670-9720	RELOCATE EXISTING WATER VALVE, INCL BOX	EA	4		

BASE BID: **$**________________________________

SUBMITTED BY (CONTRACTOR NAME) ____

ITEMS IN RED WERE EITHER ADDED OR MODIFIED.

REMAINDER OF PAGE LEFT INTENTIONALLY BLANK

ITB 25-04: OLD SPRING HOUSE LANE SHARED USE PATH					
ALTERNATE BID – Addendum 1					
ITEM NO.	**DESCRIPTION**	**UNIT**	**QTY**	**UNIT PRICE**	**EXTENDED COST**
	ROADWAY				
150-1000	TRAFIC CONTROL – OLD SPRINGHOUSE LANE SHARED USE PATH	LS	1		
205-0210	EXCAVATION – ROCK-SPECIAL PROV (AS DIRECTED BY CITY ENGINEER)	CY	25		
206-0002	BORROW EXCAV, INCL MATL-SPECIAL PROV (AS DIRECTED BY CITY ENGINEER)	CY	100		
207-0203	FOUND BKFL MATL, TP 2 (AS DIRECTED BY CITY ENGINEER)	CY	100		
210-0100	GRADING COMPLETE – OLD SPRINGHOUSELANE SHARED USE PATH	LS	1		
310-1101	GR AGGR BASE CRS, INCL MATL	TN	330		
318-3000	AGGR SURF CRS	TN	145		
402-1802	RECYCLED ASPHALT CONC PATCHING, INCL BITUM MATL & H LIME	TN	100		
402-1812	RECYCLED ASPH CONC LEVELING, INCL BITUM MATL & H LIME	TN	5		
402-3130	RECYCLED ASPH CONC 12.5 MM SUPERPAVE, GP 2 ONLY, INCL BITUM MATL & H LIME	TN	288		
402-3190	RECYCLED ASPH CONC 19 MM SUPERPAVE, GP 1 OR 2,INCL BITUM MATL & H LIME	TN	50		
413-0750	BITUM TACK COAT	GL	385		
415-5000	ASPHALTIC CONCRETE OPEN GRADED CRACK RELIEF INTERLAYER, GP 2 ONLY, INCL BITUM MATL & H LIME	TN	175		
432-0210	MILL ASPH CONC PVMT, 2-1/2 IN DEPTH	SY	3,060		
441-0104	CONC SIDEWALK, 4 IN	SY	490		
441-0106	CONC SIDEWALK, 6 IN	SY	620		
441-0108	CONC SIDEWALK, 8 IN	SY	180		
441-5002	CONC HEADER CURB, 6 IN, TP 2	LF	20		
441-5004	CONC HEADER CURB, 10 IN, TP 4	LF	70		
441-6216	CONC CURB & GUTTER, 8 IN X 24 IN, TP 2	LF	1,810		
515-2050	HANDRAIL, SPECIAL DESIGN	LF	410		
550-5180	STORM DRAIN PIPE, 18 IN, CLASS III	LF	109		
550-5242	STORM DRAIN PIPE, 24 IN, CLASS IV	LF	32		
550-5420	STORM DRAIN PIPE, 42 IN, CLASS III	LF	140		
611-3010	RECONSTR DROP INLET, GP 1	EA	1		
611-3030	RECONSTR STORM SEWER MANHOLE, TP 1	EA	1		
668-2100	DROP INLET, GP 1	EA	3		

668-2110	DROP INLET, GP 1, ADDL DEPTH	LF	1		
668-2200	DROP INLET, GP 2	EA	1		
668-2210	DROP INLET, GP 2, ADDL DEPTH	LF	2		
668-4300	STORM SEWER MANHOLE, TP 1	EA	2		
668-4311	STORM SEWER MANHOLE, TP 1, ADDL DEPTH, CL 1	LF	2		
668-4312	STORM SEWER MANHOLE, TP 1, ADDL DEPTH, CL 2	LF	6		
	PERMANENT EROSION CONTROL				
700-9300	SOD	SY	710		
	TEMPORARY EROSION CONTROL				
163-0232	TEMPORARY GRASSING	AC	1		
163-0240	MULCH	TN	15		
163-0300	CONSTRUCTION EXIT	EA	1		
163-0550	CONSTRUCT AND REMPOVE INLET SEDIMENT TRAP	EA	8		
165-0010	MAINTENANCE OF TEMPORARY SILT FENCE, TP A	LF	50		
165-0030	MAINTENANCE OF TEMPORARY SILT FENCE, TP C	LF	190		
165-0101	MAINTENANCE OF CONSTRUCTION EXIT	EA	1		
165-0105	MAINTENANCE OF INLET SEDIMENT TRAP	EA	8		
171-0010	TEMPORARY SILT FENCE, TP A	LF	100		
171-0030	TEMPORARY SILT FENCE, TP C	LF	380		
700-8000	FERTILIZER MIXED GRADE	TN	2		
	SIGNING AND MARKING				
636-1033	HIGHWAY SIGNS, TP 1 MATL, REFL SHEETING, TP 9	SF	4		
636-1036	HIGHWAY SIGNS, TP 1 MATL, REFL SHEETING, TP 11	SF	30		
636-2070	GALV STEEL POSTS, TP 7	LF	77		
653-0120	THERMOPLASTIC PVMT MARKING, ARROW TP 1	EA	2		
653-1501	THERMOPLASTIC SOILD TRAF STRIPE, 5 IN, WHITE	LF	80		
653-1502	THERMOPLASTIC SOILD TRAF STRIPE, 5 IN, YELLOW	LF	2,000		
653-1704	THERMOPLASTIC SOLID TRAF STRIPE, 24 IN, WHITE	LF	32		
653-1804	THERMOPLASTIC SOLID TRAF STRIPE, 8 IN, WHITE	LF	400		
653-3501	THERMOPLASTIC SKIP TRAF STRIPE, 5 IN, WHITE	GLF	30		
653-6004	THERMOPLASTIC TRAF STRIPING, WHITE	SY	96		
653-6006	THERMOPLASTIC TRAF STRIPING, YELLOW	SY	43		
654-1001	RAISED PVMT MARKERS TP 1	EA	49		

654-1003	RAISED PVMT MARKERS TP 3	EA	4		
659-5013	HOT APPLIED PREFORMED PVMT MKG. WORDS AND/OR SYMBOLS, WHITE TP P	EA	0		
	RETAINING WALLS				
500-3201	CLASS B CONCRETE, RETAINING WALL-GRANITE FACED	CY	176		
	WATER AND SEWER				
611-5592	RELOCATE WATER METER	EA	2		
660-2600	SEWER CLEANOUTS	EA	1		
670-1650	BACKFLOW PREVENTION ASSEMBLY	EA	2		
670-9710	RELOCATE EXISTING FIRE HYDRANT	EA	1		
670-9720	RELOCATE EXISTING WATER VALVE, INCL BOX	EA	4		

ALTERNATE BID: **$____________________________________**

SUBMITTED BY (CONTRACTOR NAME) ____

ITEMS IN RED WERE EITHER ADDED OR MODIFIED.

REMAINDER OF PAGE LEFT INTENTIONALLY BLANK

The Unit Price Bid Items provided for in the Bid Schedule are intended to be the only pay items under which the Contractor will be compensated for work described above. The Contractor shall examine the requirements of the work and the pay items in the Bid Schedule and include in the unit prices submitted all labor, equipment, materials, appurtenances, overhead, profit, vehicles, and all other things incidental for the completion of the work as specified.

The City of Dunwoody requires pricing to remain firm for the duration of the contract. Failure to hold firm pricing for the term of the contract will be sufficient cause for the City to declare bid non-responsive.

Certification of Non-Collusion in Bid Preparation ____

Signature Date

Termination for Cause: The City may terminate this agreement for cause upon ten days prior written notice to the Contractor of the Contractor's default in the performance of any term of this agreement. Such termination shall be without prejudice to any of the City's rights or remedies by law.

Termination for Convenience: The City may terminate this agreement for its convenience at any time upon a 30-day written notice to the Contractor. In the event of the City's termination of this agreement for convenience, the Contractor will be paid for those services actually performed. Partially completed performance of the agreement will be compensated based upon a signed statement of completion to be submitted by the Contractor, which shall itemize each element of performance.

Termination for fund appropriation: The City may unilaterally terminate this Agreement due to a lack of funding at any time by written notice to the Contractor. In the event of the City's termination of this Agreement for fund appropriation, the Contractor will be paid for those services actually performed. Partially completed performance of the Agreement will be compensated based upon a signed statement of completion to be submitted by the Service Provider which shall itemize each element of performance.

Acknowledgement is hereby made of the following Addendum(s) received since issuance of the Contract Documents (identified by number)

Addendum No.	Date	Initial
____________	____________________	________________
____________	____________________	________________
____________	____________________	________________
____________	____________________	________________

In compliance with the attached specifications, the undersigned offers and agrees to furnish any or all of the items upon which prices are bid, at the price set opposite each item, within the time specified in the Bid Documents.

Legal Business Name ____________________________________

Federal Tax ID____

Address ____

____

Does your company currently have a location within the City of Dunwoody? Yes ☐ No ☐

Representative Printed Name ____

Representative Signature ____

Printed Name ____

Telephone Number ____

Email Address ____

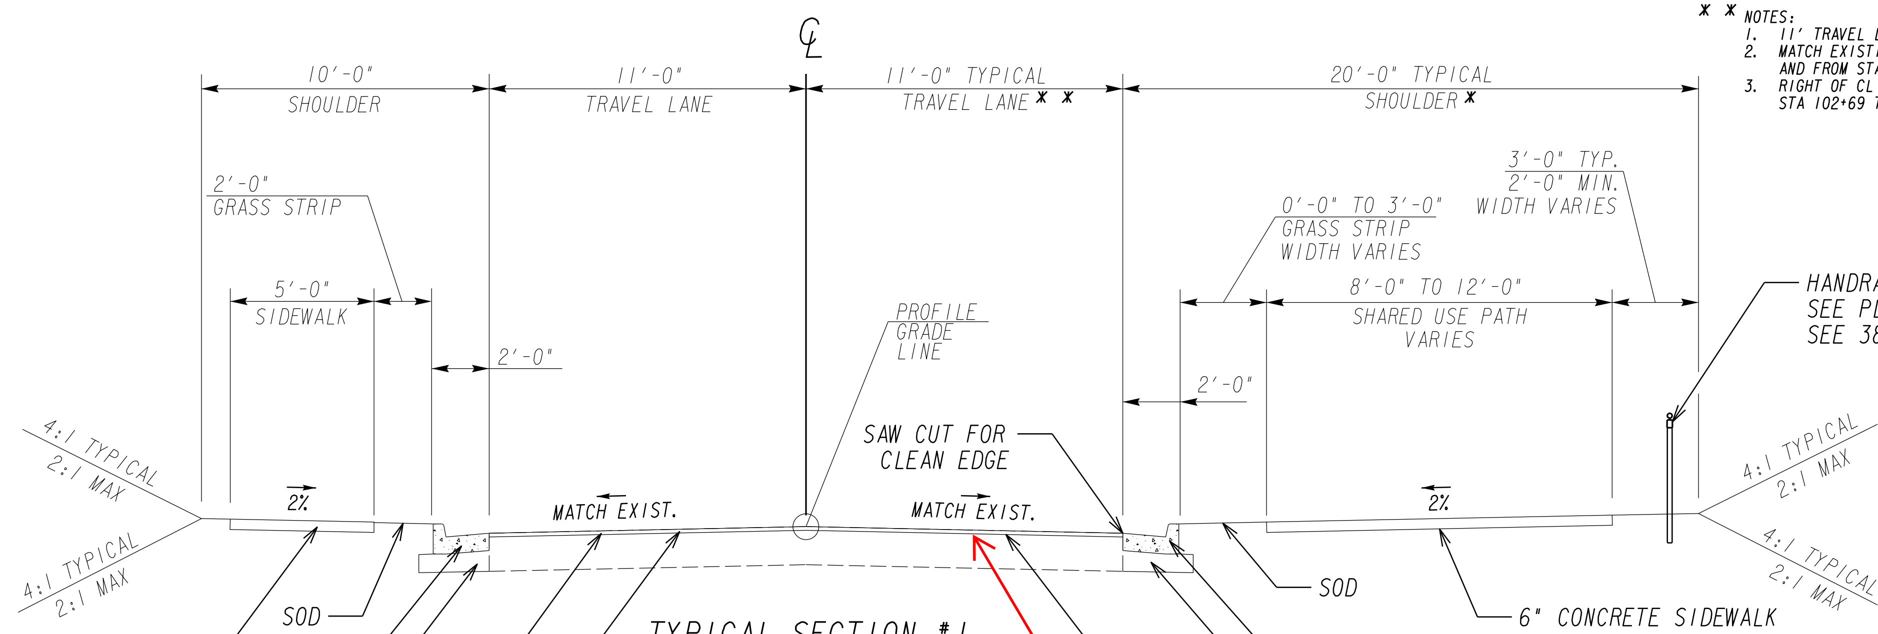

NOTE:
CONTRACTOR TO GRADE LEFT SHOULDER TO DRAIN AND TIE FILL OR CUT SLOPES INTO EXISTING GROUND WITHIN EXISTING RIGHT-OF-WAY AND WITHOUT IMPACTING EXISTING PARKING LOT.

TYPICAL SECTION #1

OLD SPRING HOUSE LANE
STA. 100+43 TO STA. 111+28

* * NOTES:
1. 11' TRAVEL LANE FROM STA 102+69 TO STA 105+78
2. MATCH EXISTING LANE WIDTH FROM STA 106+45 TO STA 106+87 AND FROM STA 108+37 TO STA 111+28
3. RIGHT OF CL TO BE AT CONSISTENT 2.5% SE FROM STA 102+69 TO STA 106+85.

* NOTES:
1. SEE TABLE BELOW FOR SHOULDER DIMENSIONS.
2. SHOULDER SLOPES AWAY FROM ROAD IN AREAS WITH FILL. SEE XS FOR DETAILS.
   - STA. 102+47 TO STA. 102+75
   - STA. 106+40 TO STA. 106+87
   - STA. 110+55 TO STA. 111+28

STATION RANGE	GRASS STRIP WIDTH	PATH WIDTH	TOTAL SHOULDER WIDTH
100+43 TO 101+87	N/A	N/A	N/A
101+87 TO 102+47	DRWY	DRWY	DRWY
102+47 TO 102+95	6' TO 3'	12'	23' TO 20'
102+95 TO 105+35	3'	12'	20'
105+35 TO 105+55	3'	12' TO 10'	20'
105+55 TO 105+65	3'	10'	20'
105+65 TO 105+78	3'	10' TO 12'	20'
105+75 TO 106+45	DRWY	DRWY	DRWY
106+45 TO 106+73	2'	12'	18'
106+73 TO 106+87	2' TO 3'	12'	18' TO 19'
106+87 TO 109+52	EXIST.	EXIST.	EXIST.
109+52 TO 110+06	3' TO 2'	12'	19' TO 18'
110+06 TO 110+68	DRWY	DRWY	DRWY
110+68 TO 110+98	2'	10'	18'
110+98 TO 111+08	2' TO 0'	10'	18' TO 14'
111+08 TO 111+28	0'	10' TO 8'	14' TO 10'

HEADER CURB DETAIL

STA 106+45 TO STA 106+78
STA 110+15 TO STA 110+22
STA 110+50 TO STA 110+58
STA 110+70 TO STA 111+05

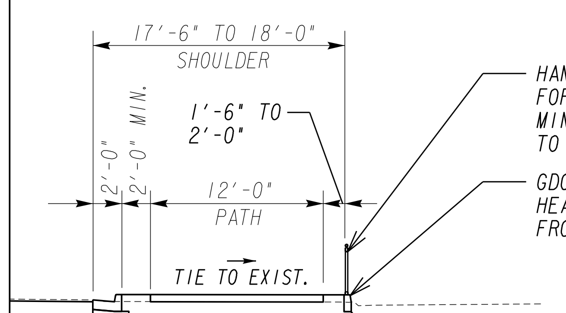

HANDRAIL, SEE DWG 38-0001 FOR DETAILS. INSTALL 1'-0" MINIMUM FROM PATH OR MOUNTED TO CURB AS DIRECTED BY ENGINEER

GDOT STD 9032B
HEADER CURB HEIGHT VARIES FROM 6" TO 10"

HEADER CURB TO BE INSTALLED ADJACENT TO PARKING LOT. FROM STA 110+50 TO STA 110+58, HEADER CURB TO BE INSTALLED ADJACENT TO EXISTING CURB & GUTTER TO REMAIN

WALL DETAIL

STA 102+90 TO STA 105+85

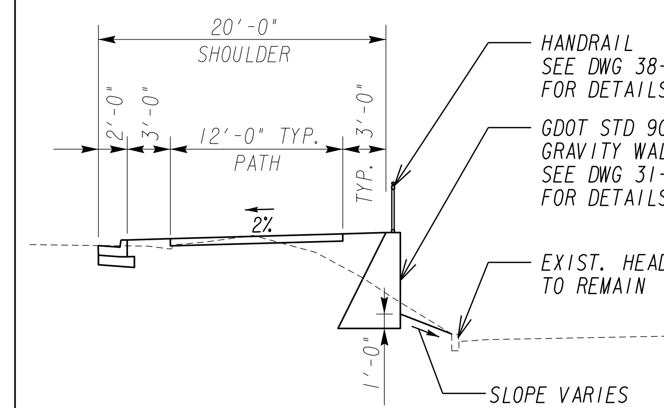

HANDRAIL
SEE DWG 38-0001
FOR DETAILS

GDOT STD 9031L
GRAVITY WALL
SEE DWG 31-0001
FOR DETAILS

EXIST. HEADER CURB TO REMAIN

SLOPE VARIES
6:1 TYPICAL FROM
STA 120+15 TO STA 120+25

FOR PAVEMENT SECTION FOR PAVEMENT PATCHING, REFER TO DETAIL ON DRAWING 38-0002. COSTS TO BE INCLUDED IN PRICE BID FOR STORM DRAIN PIPE.

City of Dunwoody Georgia

PDP PRACTICAL DESIGN PARTNERS

NOT TO SCALE

REVISION DATES

TYPICAL SECTIONS

OLD SPRING HOUSE LANE

CHECKED: DATE:
BACKCHECKED: DATE:
CORRECTED: DATE:
VERIFIED: DATE:

DRAWING No.
05-0001

SUMMARY OF QUANTITIES (SOUTH SIDE)

GRADING COMPLETE
LUMP SUM

TRAFFIC CONTROL
LUMP SUM

ROADWAY ITEMS

ROADWAY ITEMS	
GRADED AGGREGATE BASE COURSE, INCL MATERIAL	170 TN
AGGREGATE SURFACE COURSE	90 TN
RECYCLED ASPH CONC LEVELING, INCL BITUM MATL & H LIME	5 TN
RECYCLED ASPH CONC 12.5 MM SUPERPAVE, GP 2 ONLY, INCL BITUM MATL & H LIME	310 TN
RECYCLED ASPH CONC 19 MM SUPERPAVE, GP 1 OR 2, INCL BITUM MATL & H LIME	30 TN
TACK COAT	415 GL ~~230 GL~~
MILL ASPH CONC PVMT, 1 1/2 IN DEPTH	3500 SY
CONC SIDEWALK, 6 IN	620 SY
CONC SIDEWALK, 8 IN	110 SY
CONCRETE HEADER CURB, 6 IN, TP 2	20 LF
CONCRETE HEADER CURB, 10 IN, TP 4	70 LF
CONC CURB & GUTTER, 8 IN X 24 IN, TP 2	780 LF
HANDRAIL SPECIAL DESIGN	410 LF

SUMMARY OF DRIVEWAY QUANTITIES

LOCATION			TYPE	WIDTH	LENGTH	RECYCLED ASPH CONC 12.5 MM SUPERPAVE, GP 2 ONLY, INCL BITUM MATL & H LIME	RECYCLED ASPH CONC 19 MM SUPERPAVE, GP 1 OR 2, INCL BITUM MATL & H LIME	TACK COAT	GR AGGR BASE CRS, INCL MATL
NO.	STA, SIDE	ROAD		LF	LF	TN	TN	GL	TN
DW#1	106+17, RT	OLD SPRING HOUSE LANE	COMMERCIAL ASPHALT	36	26	11	15	8	44
DW#2	110+36, RT	OLD SPRING HOUSE LANE	COMMERCIAL ASPHALT	20	32	11	15	8	44
TOTALS						22	30	16	88

DRIVEWAY QUANTITIES PROVIDED FOR INFORMATION ONLY. SEE ROADWAY QUANTITIES FOR PAYMENT.

RETAINING WALLS

NO.	LOCATION	SIDE	LENGTH	CLASS B CONCRETE (STD. 9031L)
			LF	CY
WALL #1	102+90 TO 105+85	RT	295	176
TOTALS				176

ALL COSTS FOR THE CONSTRUCTION OF RETAINING WALLS INCLUDING MATERIALS, LABOR & EQUIPMENT, AND GRANITE FACE PATTERN SHALL BE INCLUDED IN THE BID PRICE FOR EACH ITEM ABOVE.

Addendum 1

DRAINAGE ITEMS

STRUCTURE NUMBER	LOCATION	ROAD	STORM DRAIN PIPE 18 IN, CLASS III	STORM DRAIN PIPE 24 IN, ~~CLASS III~~ CLASS IV	STORM DRAIN PIPE 42 IN, CLASS III	DROP INLET, GP 1 GA DET 1019A, TYPE E	DROP INLET, GP 2 GA DET 1019A, TYPE E	DROP INLET, GP 2, ADDL DEPTH GA DET 1019A, TYPE E	RECONSTR MANHOLE, TYPE 1, GA STD 1011A	RECONSTR DROP INLET, GP 1, GA DET 1019A, TYPE C	MANHOLE, TYPE 1, GA STD 1011A	MANHOLE, TYPE 1, ADDL DEPTH CL 1, GA STD 1011A	MANHOLE, TYPE 1, ADDL DEPTH CL 2, GA STD 1011A
			LF	LF	LF	EA	EA	LF	EA	EA	EA	LF	LF
A-0	104+34, 41' RT	OLD SPRING HOUSE LANE								1			
A-1	104+32, 10' RT	OLD SPRING HOUSE LANE		32							1		6
A-2	105+72, 11' RT	OLD SPRING HOUSE LANE			140		1	2					
B-1	108+27, 16' RT	OLD SPRING HOUSE LANE									1	2	
B-2	108+75, 14' RT	OLD SPRING HOUSE LANE	48			1							
B-3	109+35, 14' RT	OLD SPRING HOUSE LANE	61			1							
C-1	102+44, 18' RT	OLD SPRING HOUSE LANE							1				
TOTAL			109	32	140	2	1	2	1	1	2	2	6

City of Dunwoody Georgia

PDP PRACTICAL DESIGN PARTNERS

REVISION DATES

SUMMARY QUANTITIES

OLD SPRING HOUSE LANE

CHECKED: DATE:
BACKCHECKED: DATE:
CORRECTED: DATE:
VERIFIED: DATE:

DRAWING No.
06-0001

SUMMARY OF QUANTITIES (NORTH SIDE)

ROADWAY ITEMS	
GRADED AGGREGATE BASE COURSE, INCL MATERIAL	160 TN
AGGREGATE SURFACE COURSE	55 TN
RECYCLED ASPH CONC 12.5 MM SUPERPAVE, GP 2 ONLY, INCL BITUM MATL & H LIME	15 TN
RECYCLED ASPH CONC 19 MM SUPERPAVE, GP 1 OR 2, INCL BITUM MATL & H LIME	20 TN
TACK COAT	401 GL ~~11 GL~~
CONC SIDEWALK, 4 IN	490 SY
CONC SIDEWALK, 8 IN	70 SY
CONC CURB & GUTTER, 8 IN X 24 IN, TP 2	1030 LF

REVISED BASE ITEMS	
RECYCLED ASPH CONC 12.5 MM SUPERPAVE, GP 2 ONLY, INCL BITUM MATL & H LIME	-37 TN
TACK COAT	-27 GAL
MILL ASPH CONC PVMT, 1 1/2 IN DEPTH	-440 SY
HIGHWAY SIGNS, TP 1, MATL, REFL SHEETING, TP 9	-8.66 SF
GALV, STEEL POSTS, TP 7	-26 LF
THERMOPLASTIC SOLID TRAF STRIPE, 6 IN, WHITE	-860 LF
THERMOPLASTIC SKIP TRAF STRIPE, 6 IN, WHITE	-40 LF
HOT APPLIED PREFORMED PLASTIC PVMT MKG, WORDS AND/OR SYMBOLS, WHITE, TP P	-2 EA

SUMMARY OF DRIVEWAY QUANTITIES

LOCATION			TYPE	WIDTH	LENGTH	RECYCLED ASPH CONC 12.5 MM SUPERPAVE, GP 2 ONLY, INCL BITUM MATL & H LIME	RECYCLED ASPH CONC 19 MM SUPERPAVE, GP 1 OR 2, INCL BITUM MATL & H LIME	TACK COAT	GR AGGR BASE CRS, INCL MATL
NO.	STA, SIDE	ROAD		LF	LF	TN	TN	GL	TN
DW#3	101+35, LT	OLD SPRING HOUSE LANE	COMMERCIAL ASPHALT	18	25	3	4	2	12
DW#4	104+65, LT	OLD SPRING HOUSE LANE	COMMERCIAL ASPHALT	19	25	3	4	3	12
DW#5	107+95, LT	OLD SPRING HOUSE LANE	COMMERCIAL ASPHALT	17	25	3	4	2	11
DW#6	109+51, LT	OLD SPRING HOUSE LANE	COMMERCIAL ASPHALT	27	25	6	8	4	21
TOTALS						15	20	11	56

DRIVEWAY QUANTITIES PROVIDED FOR INFORMATION ONLY. SEE ROADWAY QUANTITIES FOR PAYMENT.

SIGNING AND MARKING	
THERMOPLASTIC SOLID TRAF STRIPE, 8 IN, WHITE	210 LF

STANDARD SIGNS

STATION	ROAD NAME	INSTL NO.	CODE	SIGNS (TYPE 1) TYPE XI REFLECTIVE SHEETING			POST TYPE 7		
				SIZE	QUANTITY	SF	LF	QTY	TOTAL LF
101+22	OLD SPRING HOUSE LANE	5	R1-1	30"	1	6	13	1	13
104+51	OLD SPRING HOUSE LANE	6	R1-1	30"	1	6	13	1	13
107+82	OLD SPRING HOUSE LANE	7	R1-1	30"	1	6	13	1	13
109+31	OLD SPRING HOUSE LANE	8	R1-1	30"	1	6	13	1	13
TOTAL					4	24		4	52

EROSION CONTROL

ITEM	UNIT	TOTAL
SOD	SY	200
MULCH	TN	5
CONSTRUCT AND REMOVE INLET SEDIMENT TRAP	EA	1
MAINTENANCE OF INLET SEDIMENT TRAP	EA	1
FERTILIZER MIXED GRADE	TN	1

Addendum 1

DRAINAGE ITEMS

STRUCTURE NUMBER	LOCATION	ROAD	STORM DRAIN PIPE 18 IN, CLASS III	STORM DRAIN PIPE 24 IN, CLASS III	STORM DRAIN PIPE 42 IN, CLASS III	DROP INLET, GP 1 GA DET 1019A, TYPE E	DROP INLET, GP 2 GA DET 1019A, TYPE E	DROP INLET, GP 1 ADDL DEPTH GA DET 1019A, TYPE E
			LF	LF	LF	EA	EA	LF
D-1	107+73, 11' LT	OLD SPRING HOUSE LANE				1		1
TOTAL						1		1

City of Dunwoody Georgia

PDP PRACTICAL DESIGN PARTNERS

REVISION DATES

SUMMARY QUANTITIES

OLD SPRING HOUSE LANE (NORTH SIDE)

CHECKED: DATE:
BACKCHECKED: DATE:
CORRECTED: DATE:
VERIFIED: DATE:

DRAWING No.
06-0003

5/16/2025 1:37:14 PM | GPLOT-ORD | 21-029_13-0001.dgn | CITY OF DUNWOODY | P.I. No.
Jeff Brashears | _gplotborder-ORD-PO_dt.tbl

Addendum 1

The alternate bid should include all of the work depicted on the North side of Old Spring House Ln and is highlighted in Red. Details for this work can be found in the plans.

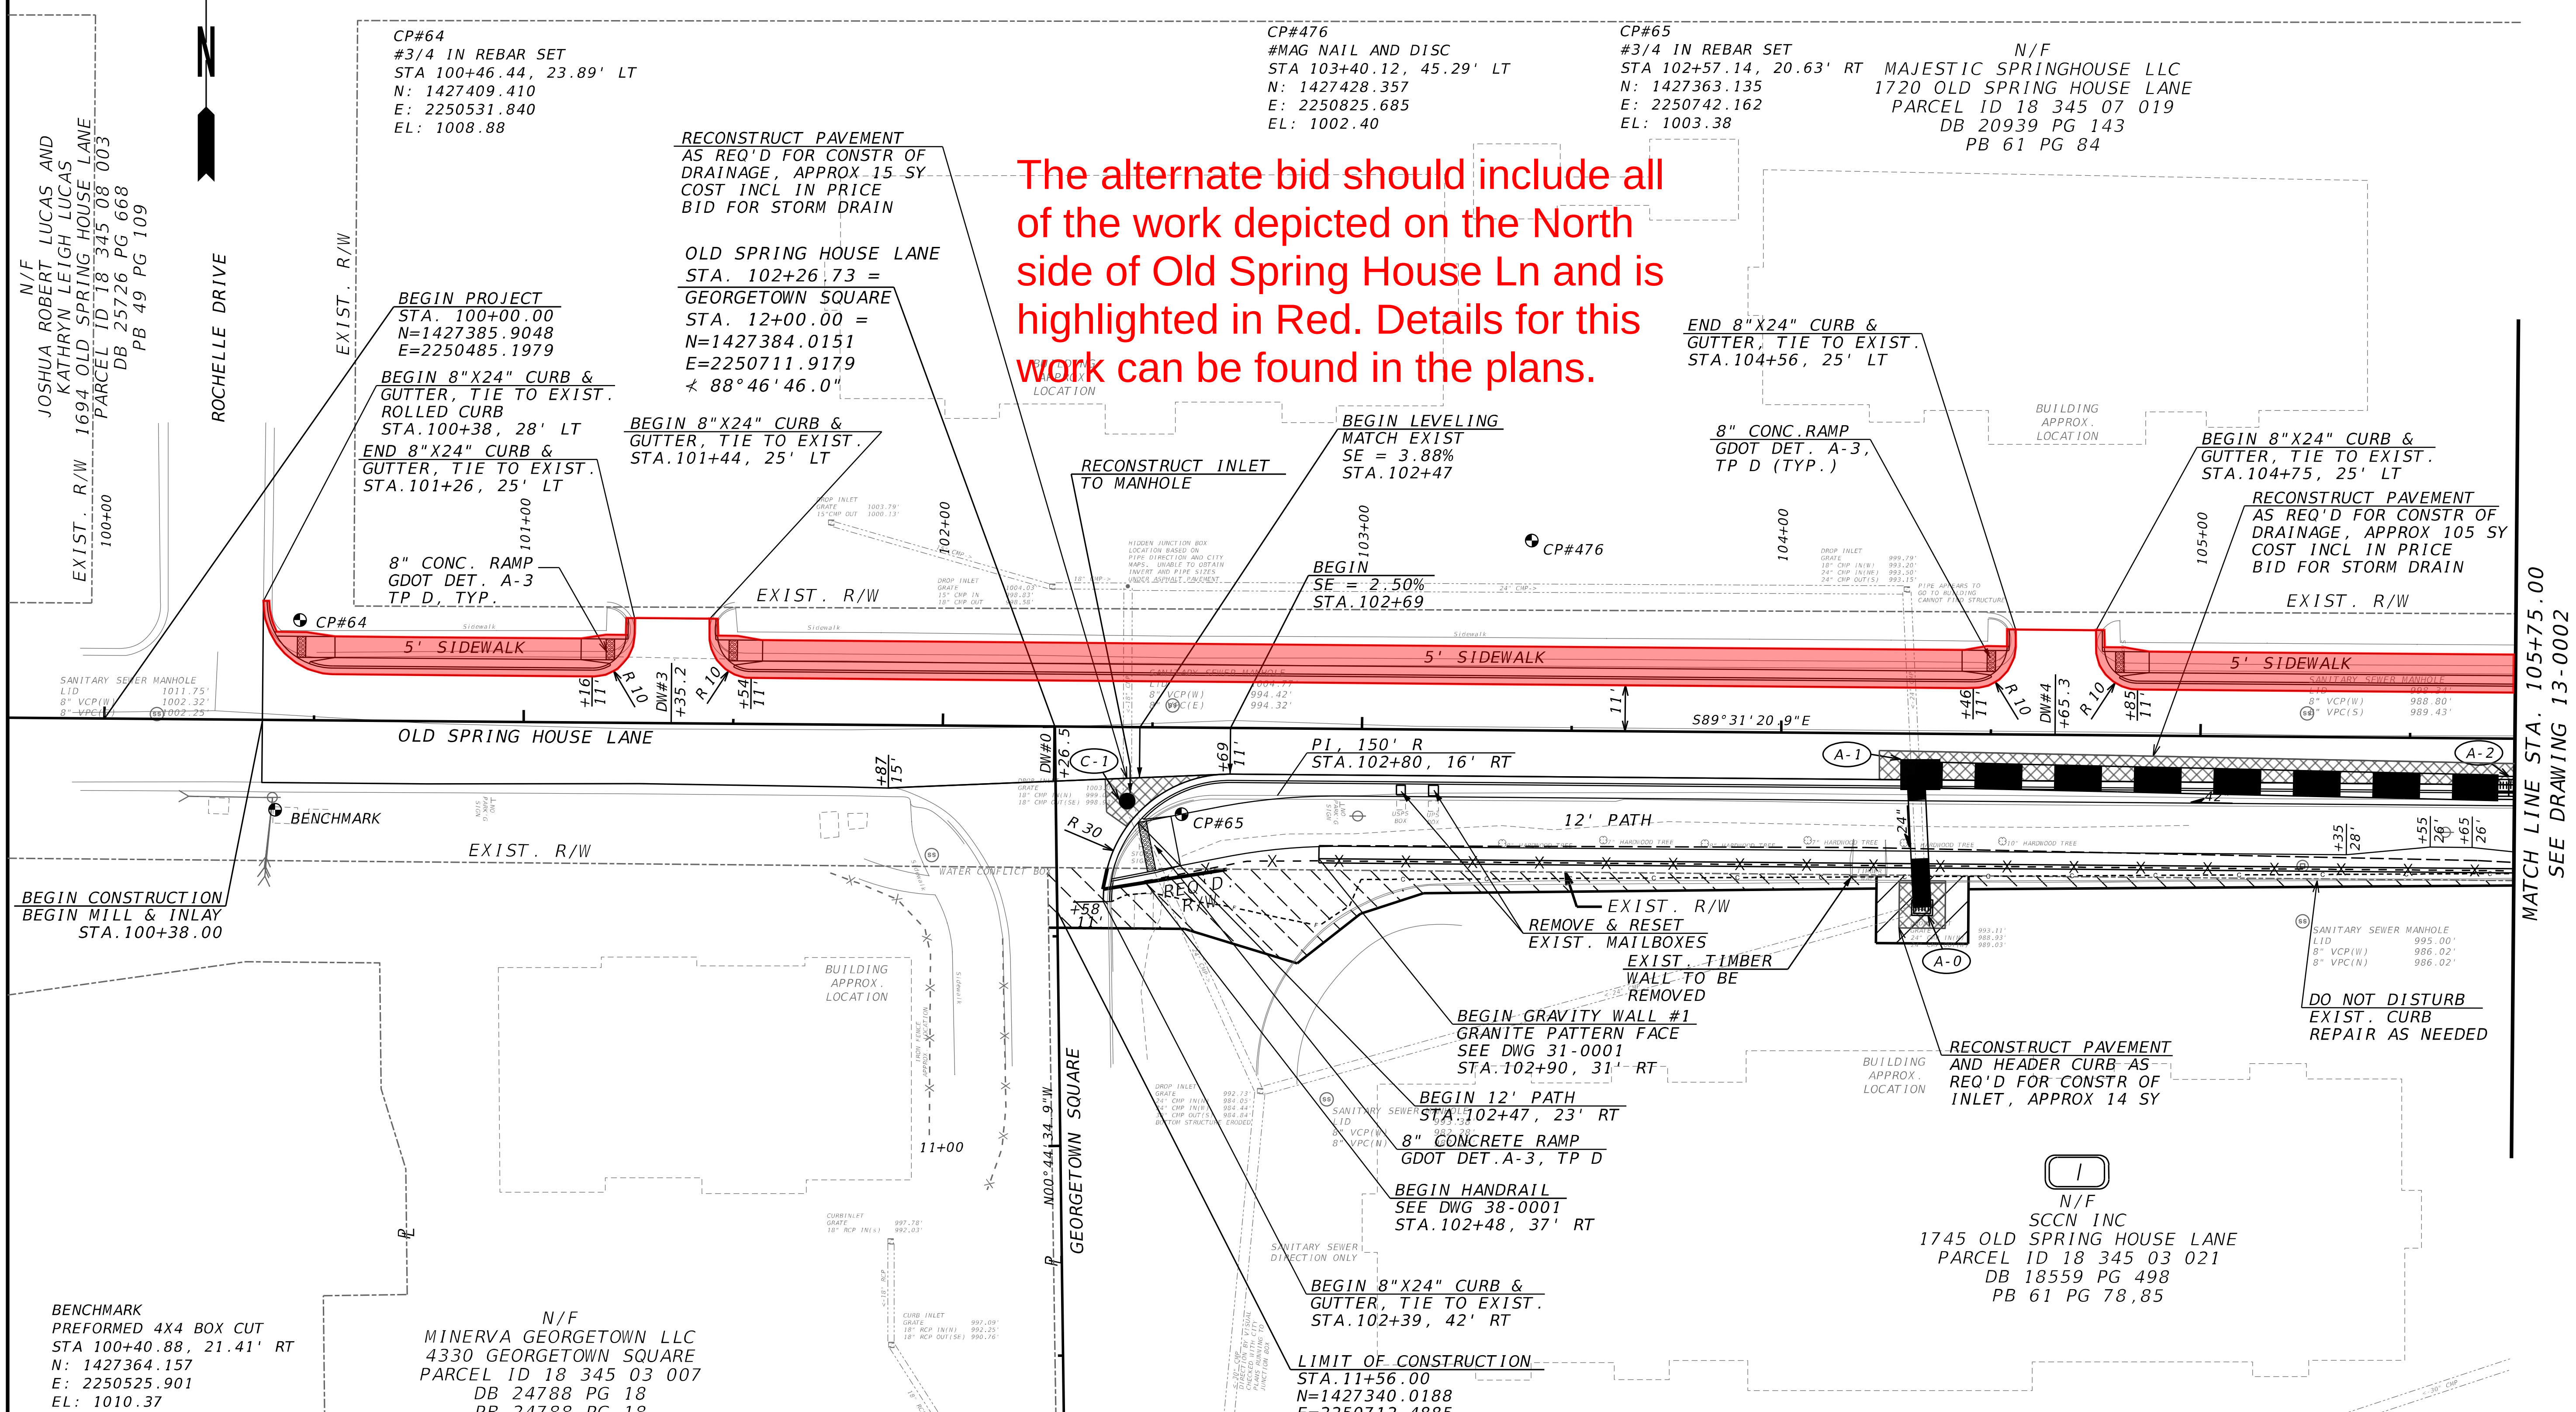

PROPERTY AND EXISTING R/W LINE
REQUIRED R/W LINE
CONSTRUCTION LIMITS
EASEMENT FOR CONSTR
& MAINTENANCE OF SLOPES
EASEMENT FOR CONSTR OF SLOPES
EASEMENT FOR CONSTR OF DRIVES

City of Dunwoody Georgia

PDP PRACTICAL DESIGN PARTNERS

SCALE IN FEET
0 20 40 80

REVISION DATES

CONSTRUCTION PLAN

OLD SPRING HOUSE LANE

CHECKED:		DATE:	
BACKCHECKED:		DATE:	
CORRECTED:		DATE:	
VERIFIED:		DATE:	

DRAWING No.
13-0001

GPLN-CE
11/05/2020

Addendum 1

The alternate bid should include all of the work depicted on the North side of Old Spring House Ln and is highlighted in Red. Details for this work can be found in the plans.

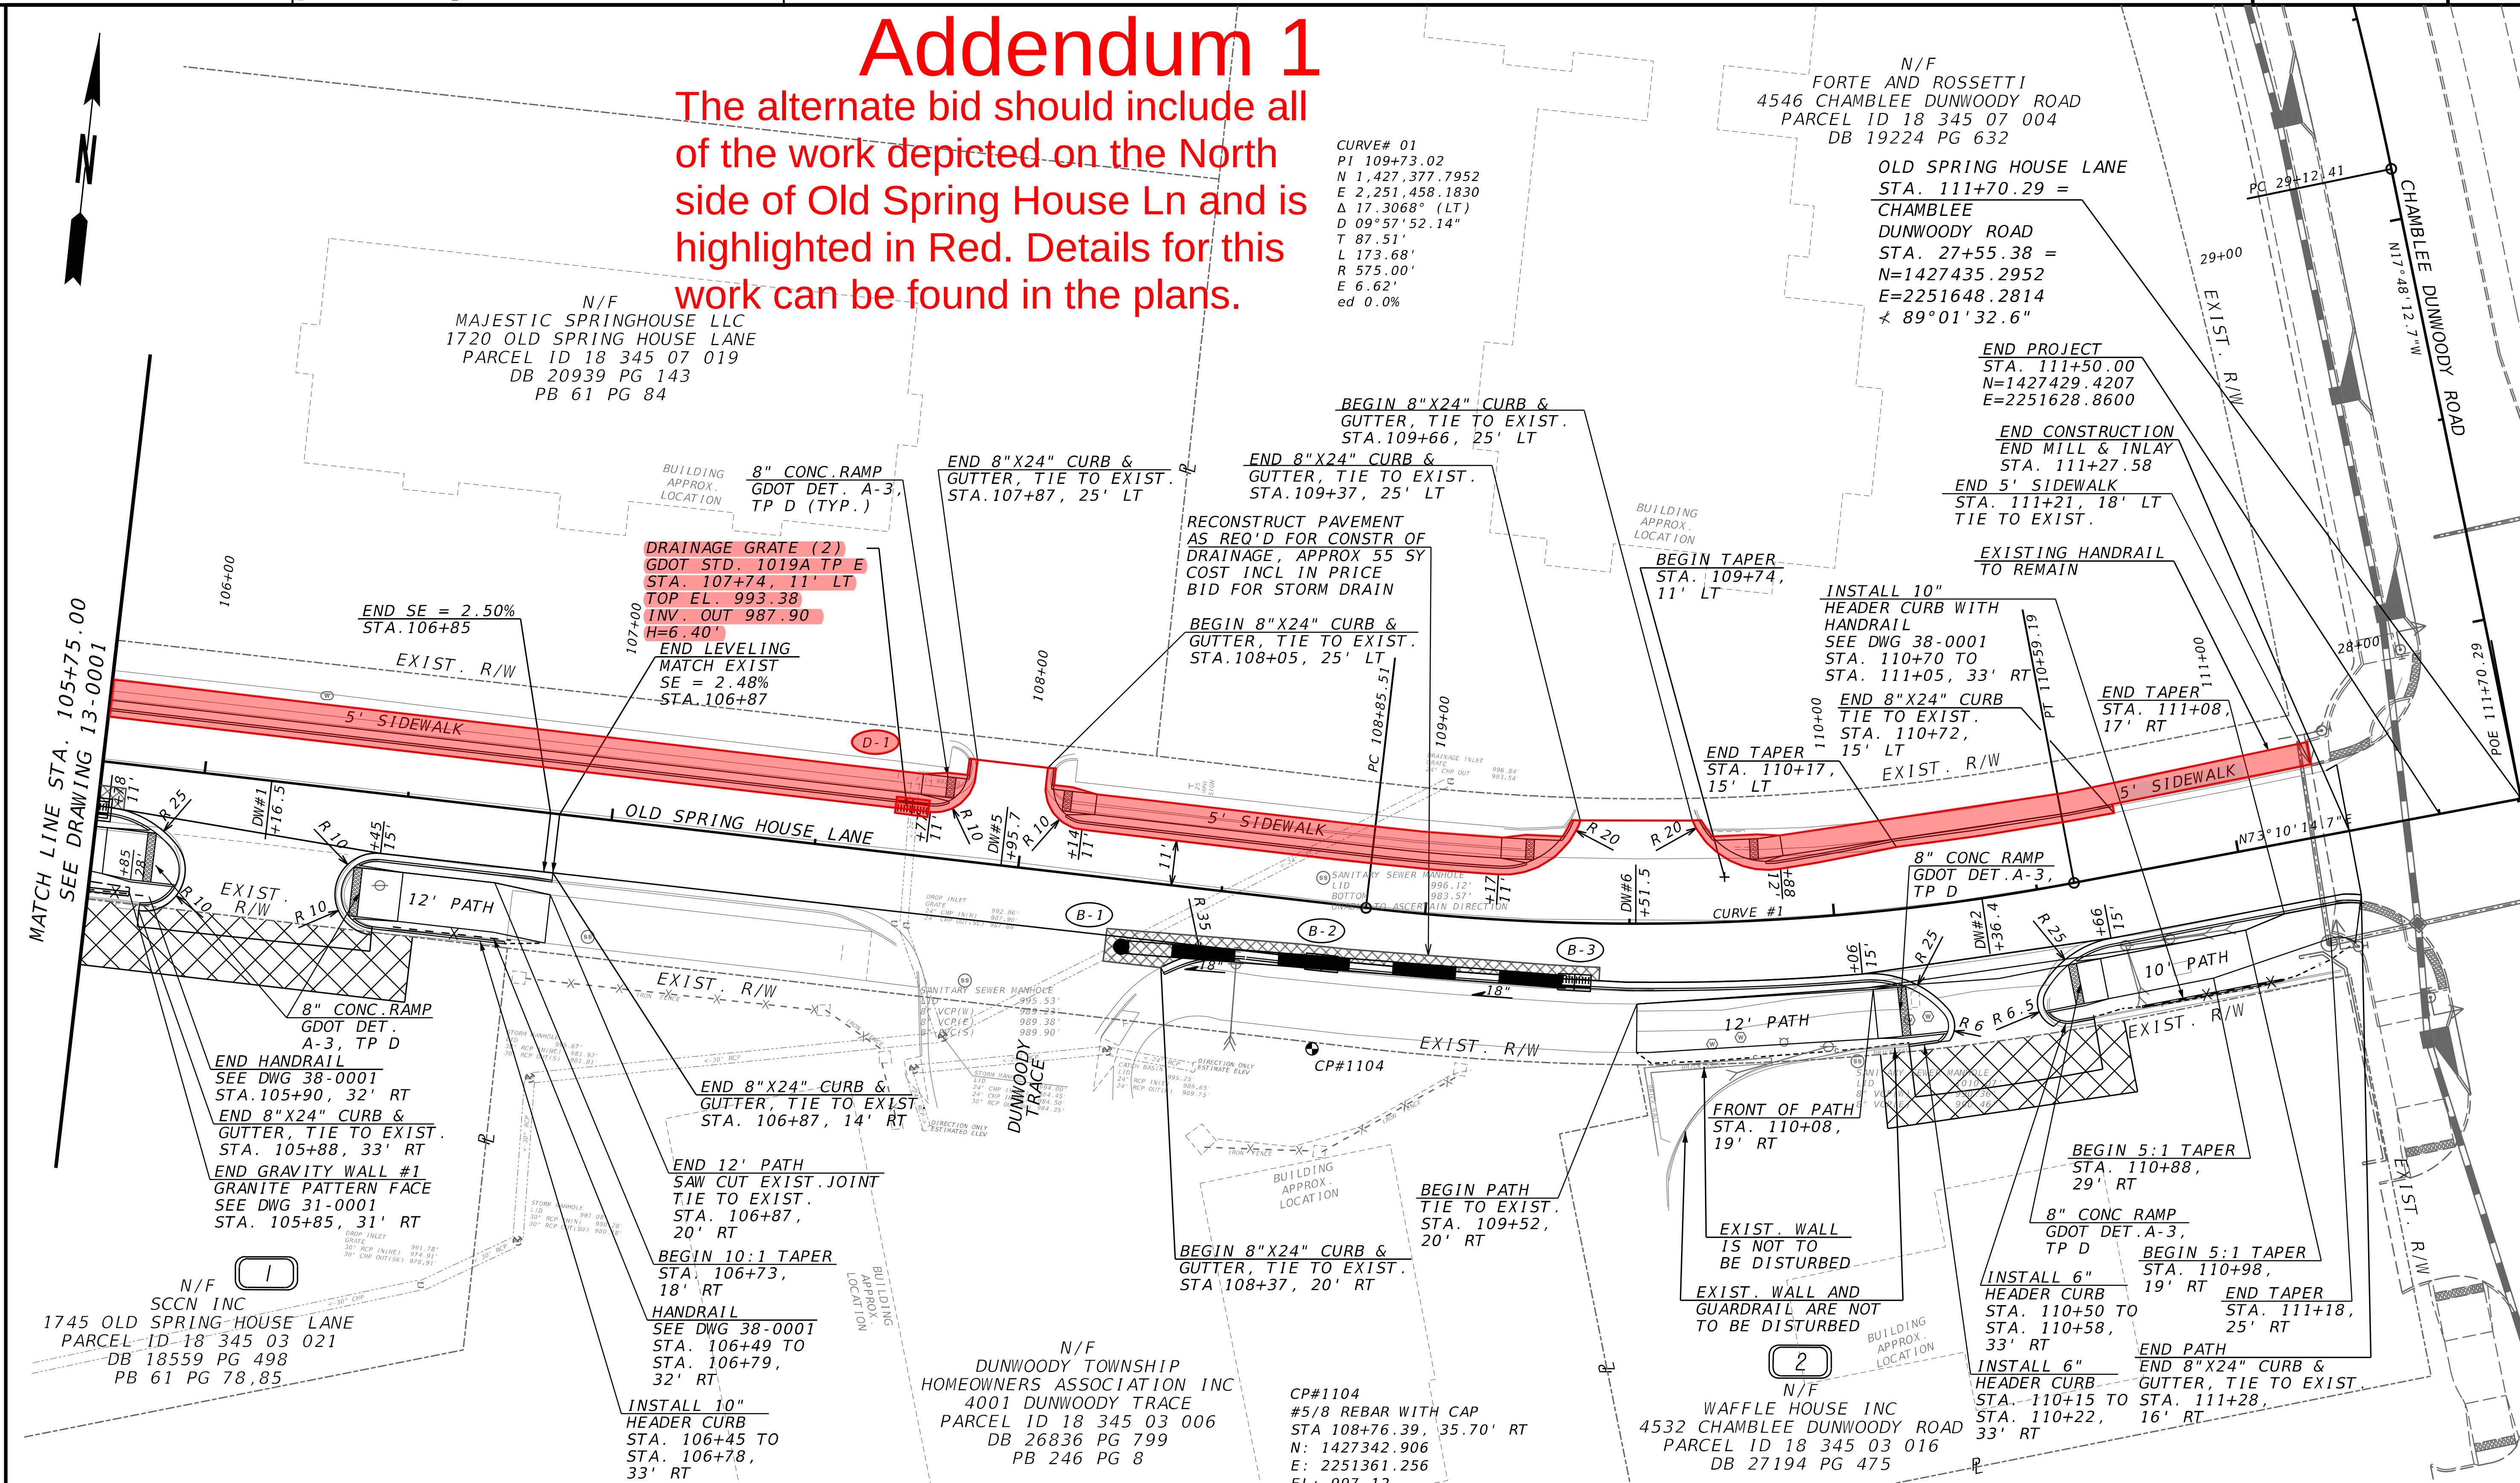

PROPERTY AND EXISTING R/W LINE	
REQUIRED R/W LINE	
CONSTRUCTION LIMITS	C F
EASEMENT FOR CONSTR & MAINTENANCE OF SLOPES	
EASEMENT FOR CONSTR OF SLOPES	
EASEMENT FOR CONSTR OF DRIVES	

City of Dunwoody Georgia

PDP PRACTICAL DESIGN PARTNERS

SCALE IN FEET
0 20 40 80

REVISION DATES

CONSTRUCTION PLAN

OLD SPRING HOUSE LANE

CHECKED:	DATE:	DRAWING No.
BACKCHECKED:	DATE:	13-0002
CORRECTED:	DATE:	
VERIFIED:	DATE:	